

SIGNAL STANDARD SCHEDULE					
No.	TYPE	FOUND. TYPE	PED. PUSH BUTN TYPE	PHASE	REMARKS
1	332 Cab.	F-332			ATSAC 2070 Controller in 332 Cabinet
2	BSL*	BSL*			
3	1	F-1			Modified F-1 Foundation Per Detail "A"
4	1	F-1			Modified F-1 Foundation Per Detail "A"
5	Davit*	CIDH**			7.6 Mast Arm; 19-4-129 Foundation
6	1	F-1			Modified F-1 Foundation Per Detail "A"
7	1	F-1			Modified F-1 Foundation Per Detail "A"
8	1	F-1			Modified F-1 Foundation Per Detail "A"
9	Davit*	CIDH**			13.7 Mast Arm; 26-4-129 Foundation

* For reference only, see Street Lighting sheet
 ** Per CALTRANS Std. Plan No. ES-7F, ES-7M, & ES-7N.




ESTIMATED MATERIAL FURNISHED BY LADOT	
UNITS	MATERIAL

ESTIMATED SALVAGE MATERIAL TO BE RETURNED TO LADOT	
UNITS	MATERIAL



NOTES :

- SEMI-ACTUATED OPERATION WITH TRANSIT PRIORITY (ATSAC 2070 CONTROLLER IN 332 CAB.)
 #1 - TIMING ONLY
 #2 - SANTA MONICA BLVD. WB
 #4 - CENTURY SQUARE PKG. NB, NB LT & NB RT
 #5 - SANTA MONICA BLVD. WB LT
 #6 - SANTA MONICA BLVD. EB & S/S PED. X-ING
 OLA (#1 & #4) - CENTURY SQUARE PARKING NB LT (DEPARTURE)
 WESTWOOD ATSAC SYSTEM
 DIRECT WIRE (CABLE) INTERCONNECT
- SEE STREET LIGHTING SHEET FOR WORK ON STREET LIGHTING FACILITIES.
- INSTALL LOOPS PER LADOT STD. DWG. NO. S-70.1A.
- INSTALL/REMOVE STRIPING, PAVEMENT MARKINGS AND SIGNS PER LADOT GEOMETRIC DESIGN NO. A-3166.

CONDUCTOR SCHEDULE		RUN																							
SIZE No.	CABLE / WIRE	1	2	3	4	5	6	7	8	9	10	11	12	13	14	15	16	17	18	19	20	21	22	23	24
5	CONDUCTOR CABLE																								
5	5 X #14	4	1	2	1	2	2	4	2																
9	CONDUCTOR CABLE																								
8	8 X #14 & 1 X #12 (COM)																								
12	CONDUCTOR CABLE																								
11	11 X #14 & 1 X #12 (COM)	1	1																						
28	CONDUCTOR CABLE																								
27	27 X #14 & 1 X #10 (COM)	1	1																						
2	SERVICE																								
14	PED PUSH BUTTON																								
16	DLC (2 PAIR)																								
16	DLC (3 PAIR)																								
16	DLC (4 PAIR)																								
18	DLC (EXISTING)																								
22	INTERCONNECT (12 PAIR)																								
22	INTERCONNECT (25 PAIR)																								
12	BUS DLC (1 PAIR)																								
	VIDEO FIBER (24 SM)																								
	CONDUIT SIZE (mm)	51	76	51	51	76	51	51	51	76	51	76	51	76	51	76	51	76	51	76	51	76	51	76	

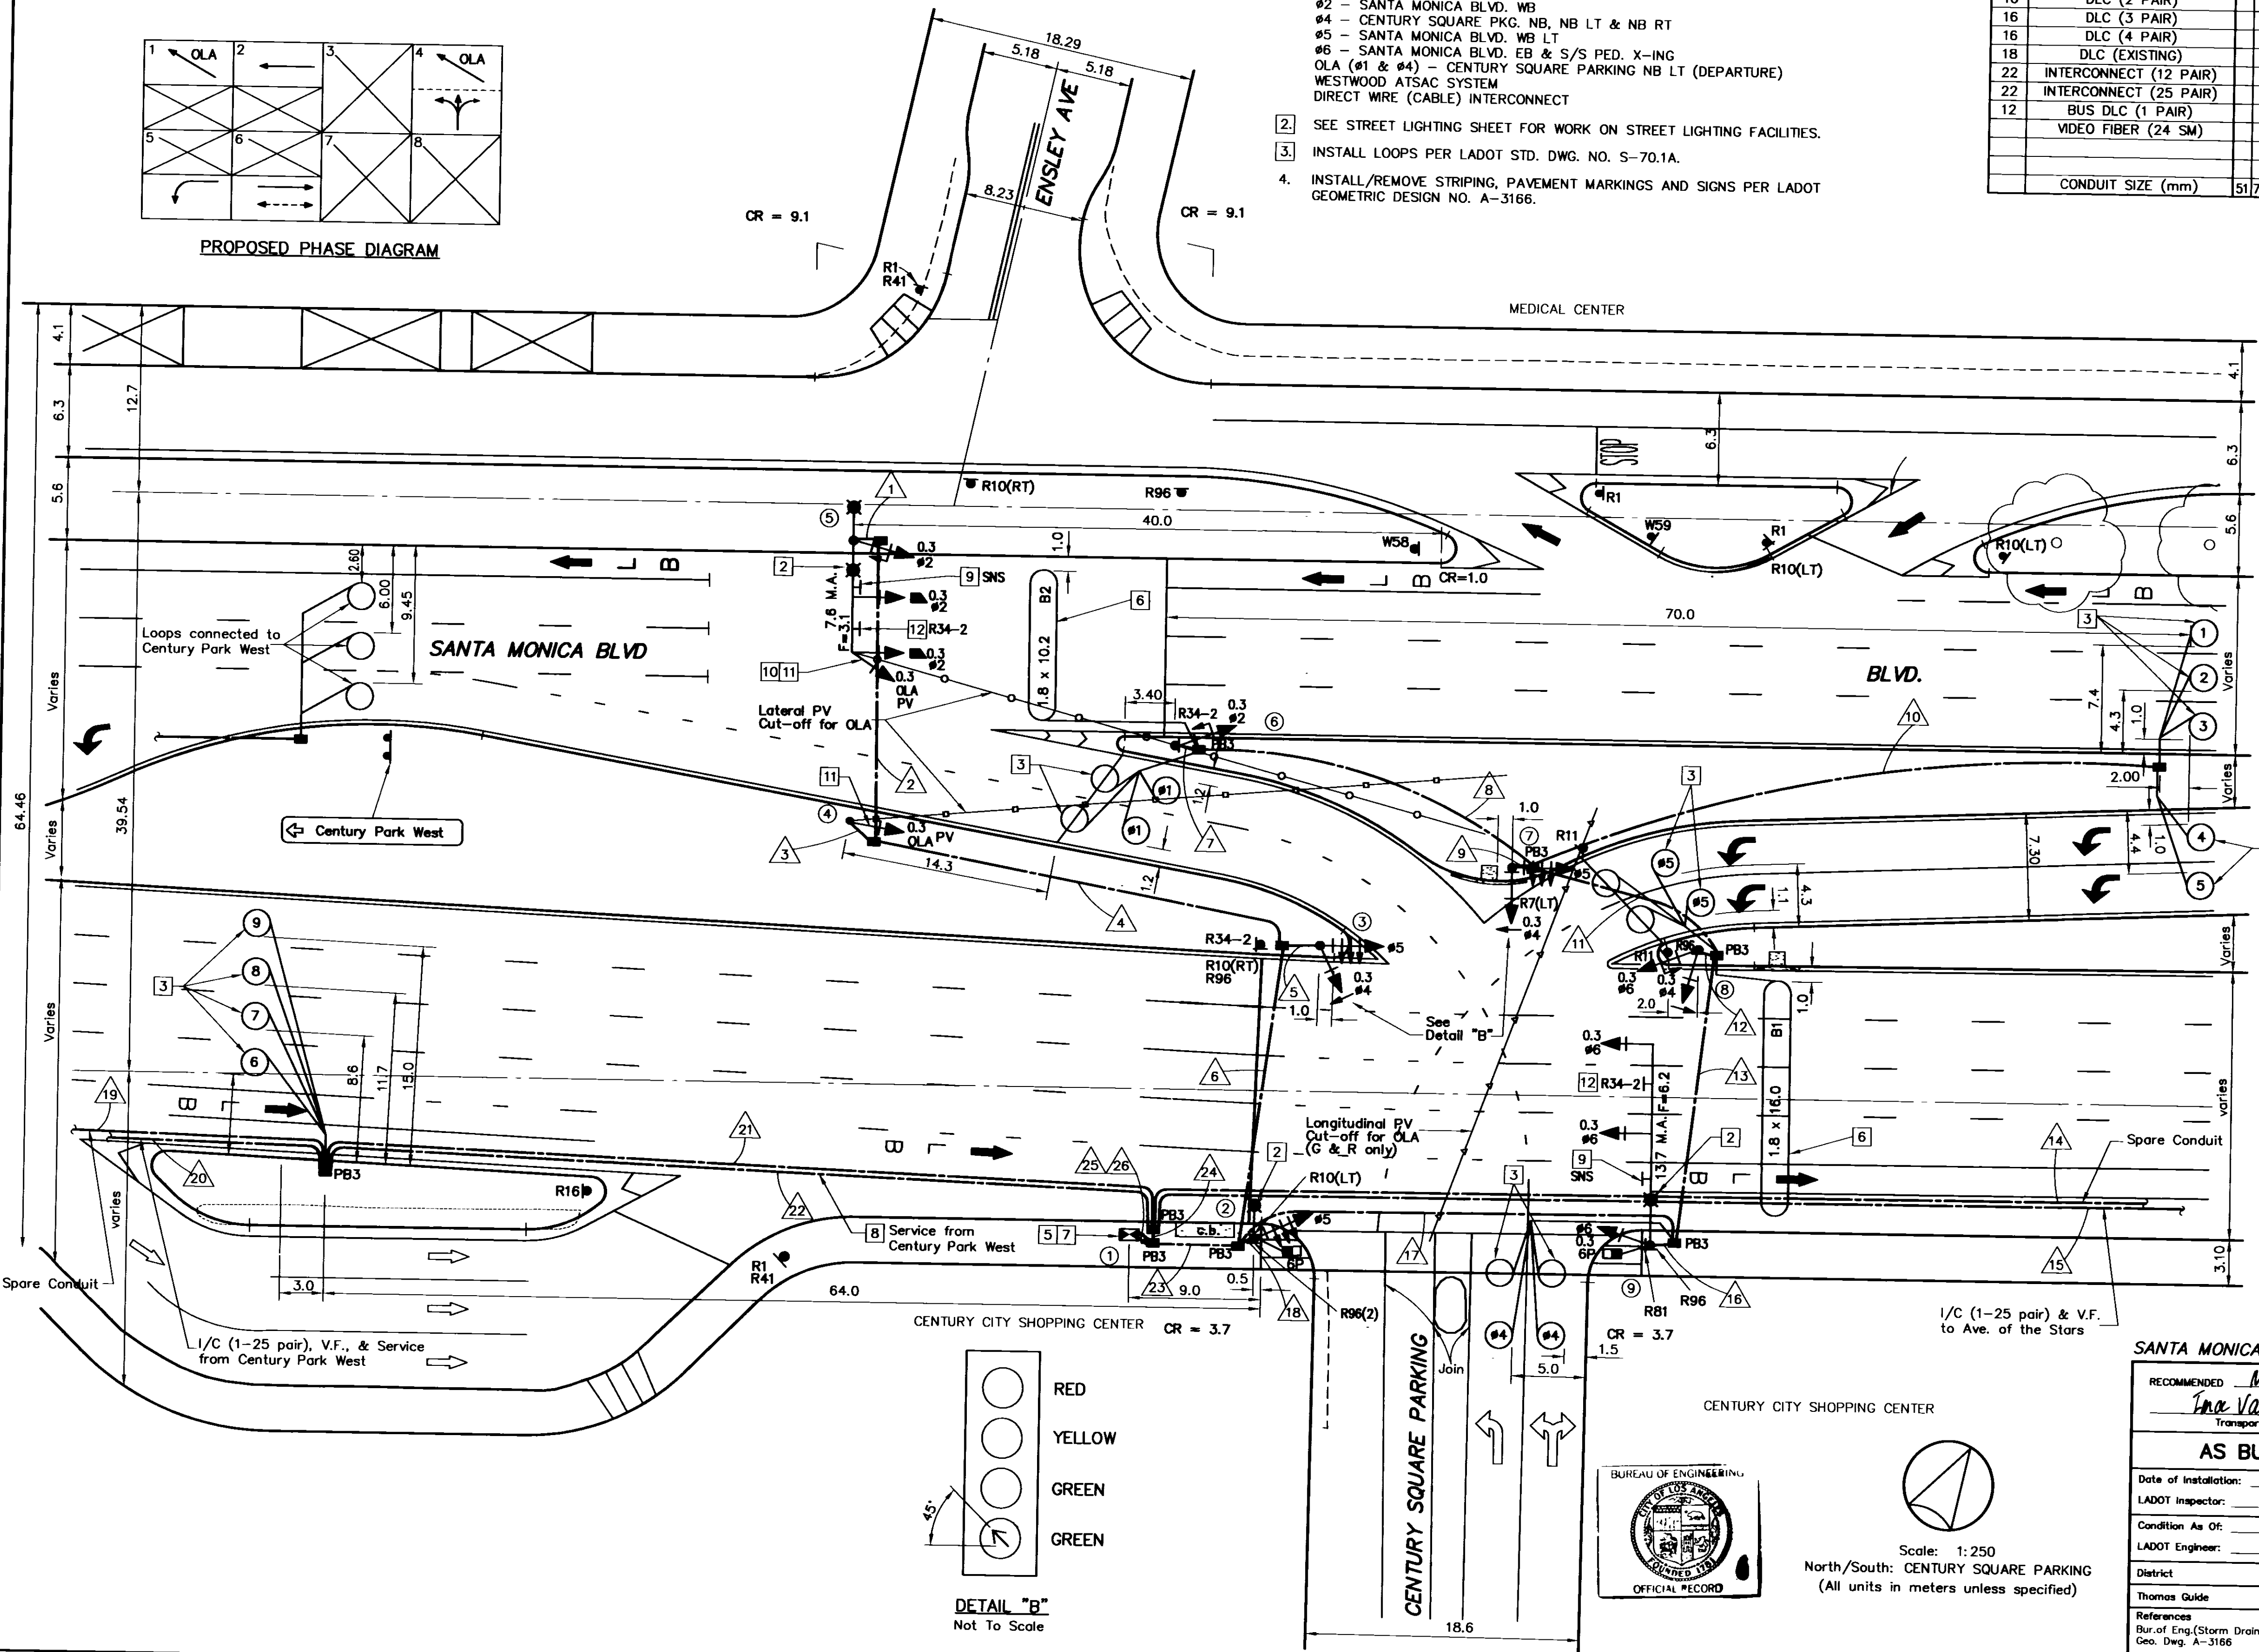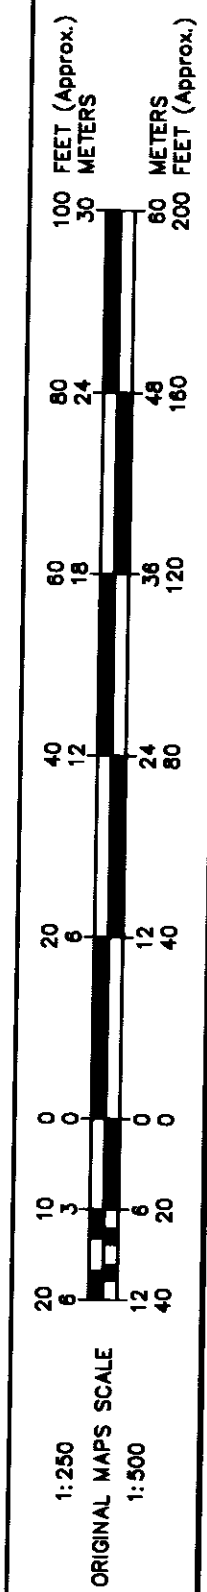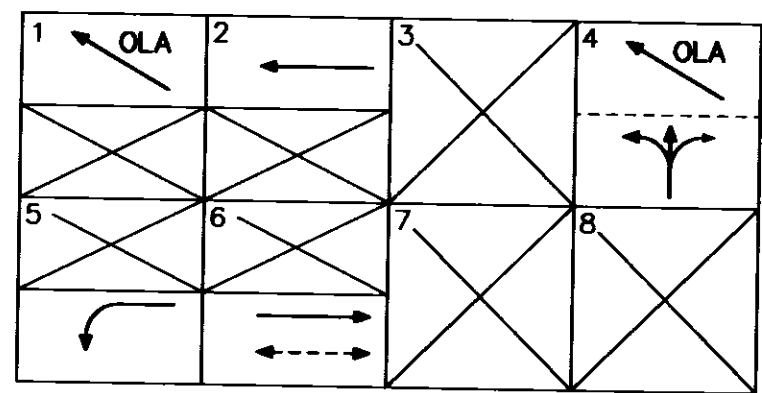

- NOTES (Continued):
- INSTALL ONE (1) TRANSIT PRIORITY SENSOR UNIT IN THE CONTROLLER PER LADOT STD. DWG. NO. S-70.3A.
 - INSTALL TRANSIT PRIORITY LOOPS PER LADOT STD. DWG. NO. S-70.1F.
 - THE CONTRACTOR SHALL FURNISH AND INSTALL A NEW CONTROLLER IN CONFORMANCE WITH THE LATEST SPECIFICATIONS AND/OR ADDENDUM FOR THE LADOT ATSAC TYPE 2070 CONTROLLER ASSEMBLY AND 332 CABINET, AND SHALL INCLUDE ALL NECESSARY AUXILIARY EQUIPMENT REQUIRED TO PROVIDE A COMPLETE AND FUNCTIONING CONTROLLER. ALL COMPONENTS AND MATERIALS SHALL BE NEW AND UNUSED. DELIVER THE COMPLETELY ASSEMBLED CONTROLLER AND CABINET FOR TESTING TO LADOT GENERAL SHOP, PIPER TECHNICAL CENTER, 555 RAMIREZ ST. AND THIRTY (30) WORKING DAYS PRIOR TO INSTALLATION.
 - INSTALL 2-#2 SERVICE WIRES FROM CENTURY PARK WEST (VAULT #1801) AND SANTA MONICA BLVD.
 - INSTALL LARGE STREET NAME SIGN PER LADOT STD. DWG. NO. S-457.0 & S-486.0
 - INSTALL MAST ARM HEAD WITH SPECIAL MAST ARM MOUNTING AB-3008 PER LADOT DWG. NO. S-63.1.4.
 - MASK PROGRAM VISIBILITY (PV) HEADS WITH BOTH THE LONGITUDINAL AND LATERAL CUT-OFFS.
 - INSTALL SIGNS AS SHOWN.

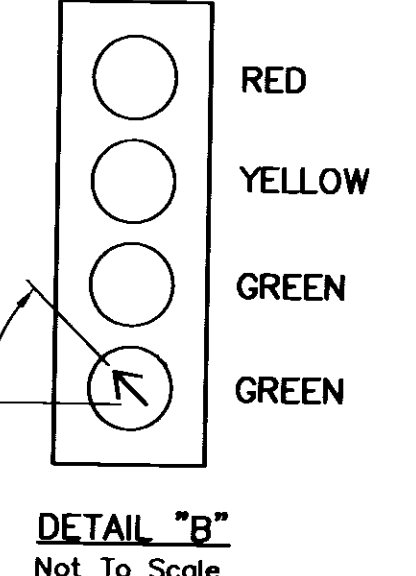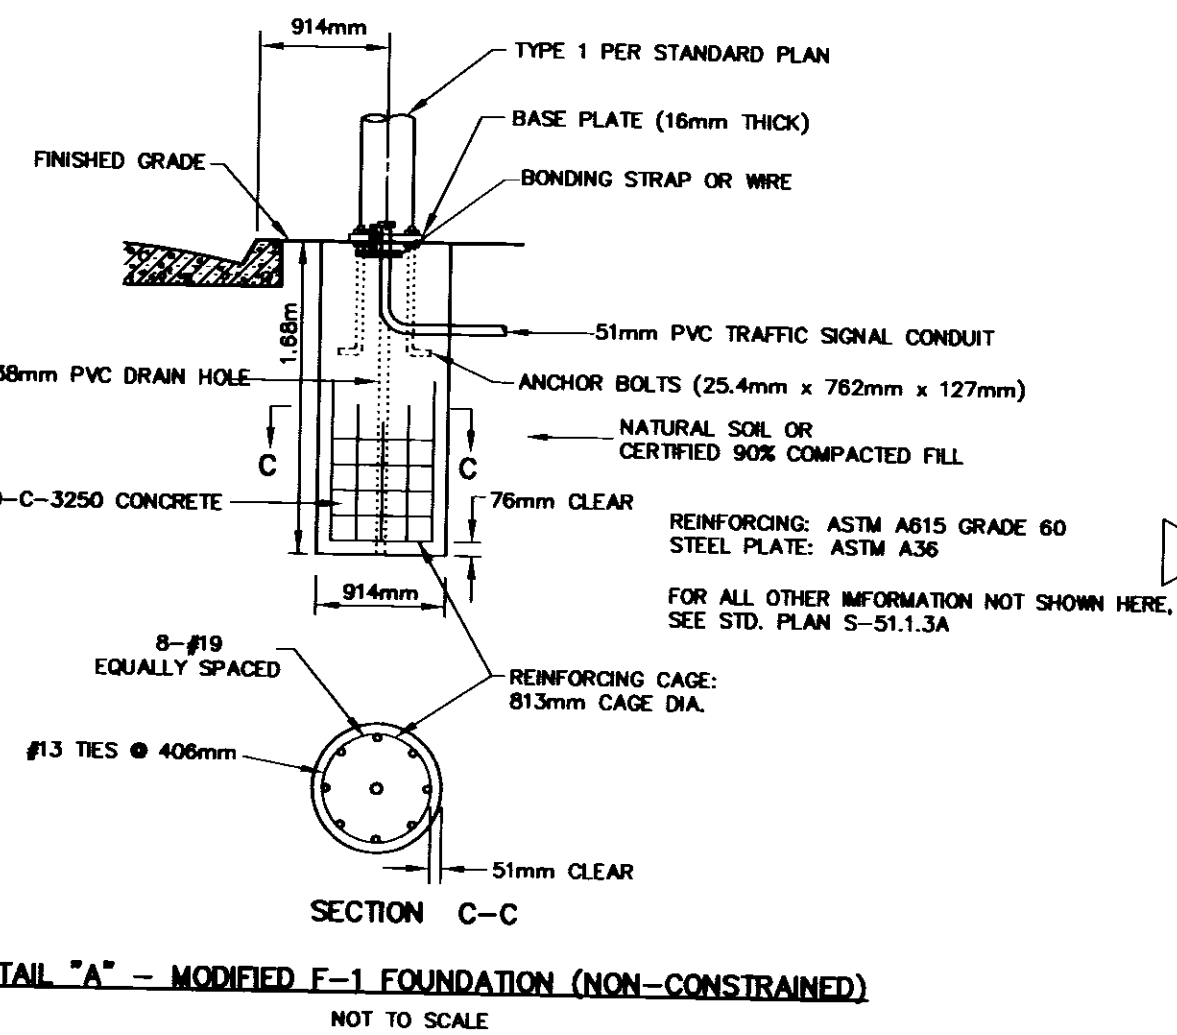

SANTA MONICA BLVD. TRANSIT PARKWAY-NEW SIGNAL

RECOMMENDED May 21, 2002 APPROVED May 21, 2002

Thao Van Doan Transportation Engineer Thomas L. Jones Senior Transportation Engineer

AS BUILT

City of Los Angeles
 DEPARTMENT OF TRANSPORTATION
 RITA L. ROBINSON, General Manager

TITLE: **CENTURY SQUARE PARKING & SANTA MONICA BLVD.**

District: WESTERN Thomas Guide: 632-D3

File Name: **17911-M5.DWG** Intersection No: **17911** Project No: **90297**

NOTICE: IF PLAN HAS NOT BEEN IMPLEMENTED WITHIN TWO (2) YEARS OF THE APPROVAL DATE, IT MUST BE RESUBMITTED TO LADOT SIGNAL DESIGN SECTION FOR REVIEW AND APPROVAL.

